

## Land and Environment Court New South Wales

<b>Medium Neutral Citation:</b>	<b>Sell &amp; Parker Pty Ltd v Minister for Planning [2017] NSWLEC 1586</b>
<b>Hearing dates:</b>	Conciliation conference on 19 September & 17 October 2017
<b>Date of orders:</b>	19 October 2017
<b>Decision date:</b>	19 October 2017
<b>Jurisdiction:</b>	Class 1
<b>Before:</b>	Maston AC
<b>Decision:</b>	See (4) below
<b>Catchwords:</b>	DEVELOPMENT APPLICATION: conciliation conference; agreement between the parties; orders
<b>Legislation Cited:</b>	Land and Environment Court Act 1979
<b>Category:</b>	Principal judgment
<b>Parties:</b>	Sell and Parker Pty Ltd (ACN 000 101 315) (Applicant) Minister for Planning (Respondent)
<b>Representation:</b>	Mr J Johnson, Allens(Applicant) Ms L Sims, Department of Planning (Respondent)
<b>File Number(s):</b>	2017/126126
<b>Publication restriction:</b>	No

### JUDGMENT

1 **COMMISSIONER:** In this matter, at or after a conciliation conference, an agreement under s 34(3) of the *Land and Environment Court Act 1979* (the Court Act) was reached between the parties as to the terms of a decision in the proceedings that was acceptable to the parties. As the presiding Commissioner, I was satisfied that the decision was one that the Court could have made in the proper exercise of its functions (this being the test applied by s 34(3) of the Court Act). As a consequence, s 34(3)(a) of the Act required me to “dispose of the proceedings in accordance with the decision”.

2

The Court Act also required me to “set out in writing the terms of the decision” (s 34(3) (b)). The orders made to give effect to the agreement constitute that document.

3 In making the orders to give effect to the agreement between the parties, I was not required to make, and have not made, any merit assessment of the issues that were originally in dispute between the parties.

4 The final orders to give effect to the parties’ agreement under s34(3) of the Land and Environment Court Act 1979 are:

(1) Leave is granted to the Applicant to rely on the following amended plans and documents:

<b>Document</b>	<b>Revision Date</b>	<b>Prepared by: (consultant)</b>
Drawing DA-1049-14 A101 Rev M	21/9/2017	Algorry Zappia and Associates Pty Ltd
Drawing DA-1049-14 A301 Rev H	27/9/2017	Algorry Zappia and Associates Pty Ltd
Drawing 14023-16-001-FH-01 Rev P4	25/9/2017	MJ Harvey and Associates Pty Ltd
Drawing SS15-3178-000-I	22/9/2017	Site Image (NSW) Pty Ltd
Drawing SS15-3178-101-J	22/9/2017	Site Image (NSW) Pty Ltd
Drawing SS15-3178-401-G	15/8/2017	Site Image (NSW) Pty Ltd
Drawing SS15-3178-402-I	22/9/2017	Site Image (NSW) Pty Ltd
Drawing SS15-3178-403-G	15/8/2017	Site Image (NSW) Pty Ltd
Drawing SS15-3178-404-G	22/9/2017	Site Image (NSW) Pty Ltd
Drawing SS15-3178-501-I	22/9/2017	Site Image (NSW) Pty Ltd
Town Planning Report	29/9/2017	Tim Ward (Ethos Urban)
Acoustic Report	25/9/2017	Renzo Tonin and Associates

(2) The Applicant is to pay the Respondent's costs thrown away by reason of the amended plans and documents listed above under section 97B of the *Environmental Planning and Assessment Act 1979* as agreed or assessed.

- (3) The appeal is upheld.
- (4) Modification application No. SSDMod 16\_8001, is approved, subject to the conditions set out in Annexure "A".

.....

John Maston

Acting Commissioner of the Land & Environment Court of NSW

[Annexure A \(75.7 KB, pdf\)](#)

[Plans \(8.24 MB, pdf\)](#)

---

DISCLAIMER - Every effort has been made to comply with suppression orders or statutory provisions prohibiting publication that may apply to this judgment or decision. The onus remains on any person using material in the judgment or decision to ensure that the intended use of that material does not breach any such order or provision. Further enquiries may be directed to the Registry of the Court or Tribunal in which it was generated.

Decision last updated: 03 November 2017

**ANNEXURE A**

***Sell and Parker Pty Limited v Minister for Planning***

**SCHEDULE 1**

<b>Application No:</b>	SSD 5041
<b>Applicant:</b>	Sell and Parker Pty Ltd
<b>Consent Authority:</b>	Land and Environment Court of NSW
<b>Development:</b>	Increasing the processing capacity of the existing metal recycling facility, including reconfiguration and expansion of the facility into the adjoining site at 23-43 Tatersall Road, Kings Park.
<b>Date of Original Consent:</b>	12 November 2015
<b>Modification:</b>	SSD 5041 MOD 1- the modification includes amendments to the site layout, design of buildings and structures and alterations and additions to existing buildings and structures

**SCHEDULE 2**

This consent is modified as follows:

**In Schedule 1**

1. In the table of definitions, insert the following definitions in alphabetical order:  
Expanded Operations The point at which the site receives or processes in excess of 90,000 tonnes per calendar year of waste  
FRNSW Fire and Rescue New South Wales  
NCC National Construction Code  
Waste As defined in the POEO Act In Schedule 2
2. Delete and replace Condition A2 as follows:  
A2. The Applicant shall carry out the Development in accordance with the:
  - (a) EIS prepared by ERM dated July 2014;
  - (b) Response to Submissions report prepared by ERM dated 7 January 2015;
  - (c) Supplementary Response to Submissions prepared by Mecone dated 30 June 2015;

- (d) Supplementary Response to Submissions prepared by Sell and Parker Pty Ltd dated 3 September 2015;
  - (e) Site layout plans and drawings (See Appendix A);
  - (f) Management and Mitigation Measures (see Appendix B);
  - (g) Modification Application SSD 5041 MOD 1 and accompanying document titled *Statement of Environmental Effects 23-43 and 45 Tattersall Road, Kings Park* dated August 2016 prepared by Higgins Planning, additional information from Higgins Planning dated 22 December 2016, further additional information from Allens and Linklaters dated 9 February 2017 and the Town Planning Report prepared by Ethos Consulting on 29 September 2017.
3. Insert Condition B35A as follows:
- B35A. Prior to:
- (i) expanded operations;
  - (ii) the issue of an Occupation Certificate; or
  - (iii) the date being 6 months after the determination of MOD 1 by the Land and Environment Court,
- (whichever is sooner), the Applicant must ensure that an appropriate sprinkler system and smoke detection system have been installed within the floc storage area in Building C to the satisfaction of FRNSW.
4. Insert Condition E35B as follows: B35B
- Prior to:
- (i) expanded operations;
  - (ii) the issue of an Occupation Certificate; or
  - (iii) the date being 7 months after the determination of MOD 1 by the Land and Environment Court,
- (whichever is sooner), the Applicant must ensure that all fire safety measures required by the NCC for Buildings A, B, & C (as shown on drawing 14023-16-001-FH-01 Rev P4) have been installed and verified through a Fire Safety Audit in accordance with Australian Standard 4655 – Fire Safety Audits, to the satisfaction of FRNSW.
5. Delete Condition B19(viii) and replace as follows:
- (viii) installation of appropriate dust screens at the property boundary and replacement of dust screens and shade cloths at the Tattersall Road boundary of the 45 Tattersall Road site.

6. Replace all drawings in Appendix A with the following:








**WATER STORAGE CAPACITY IN ACCORDANCE WITH CLAUSE 4.2 OF AS 2419 2005 PART 1**





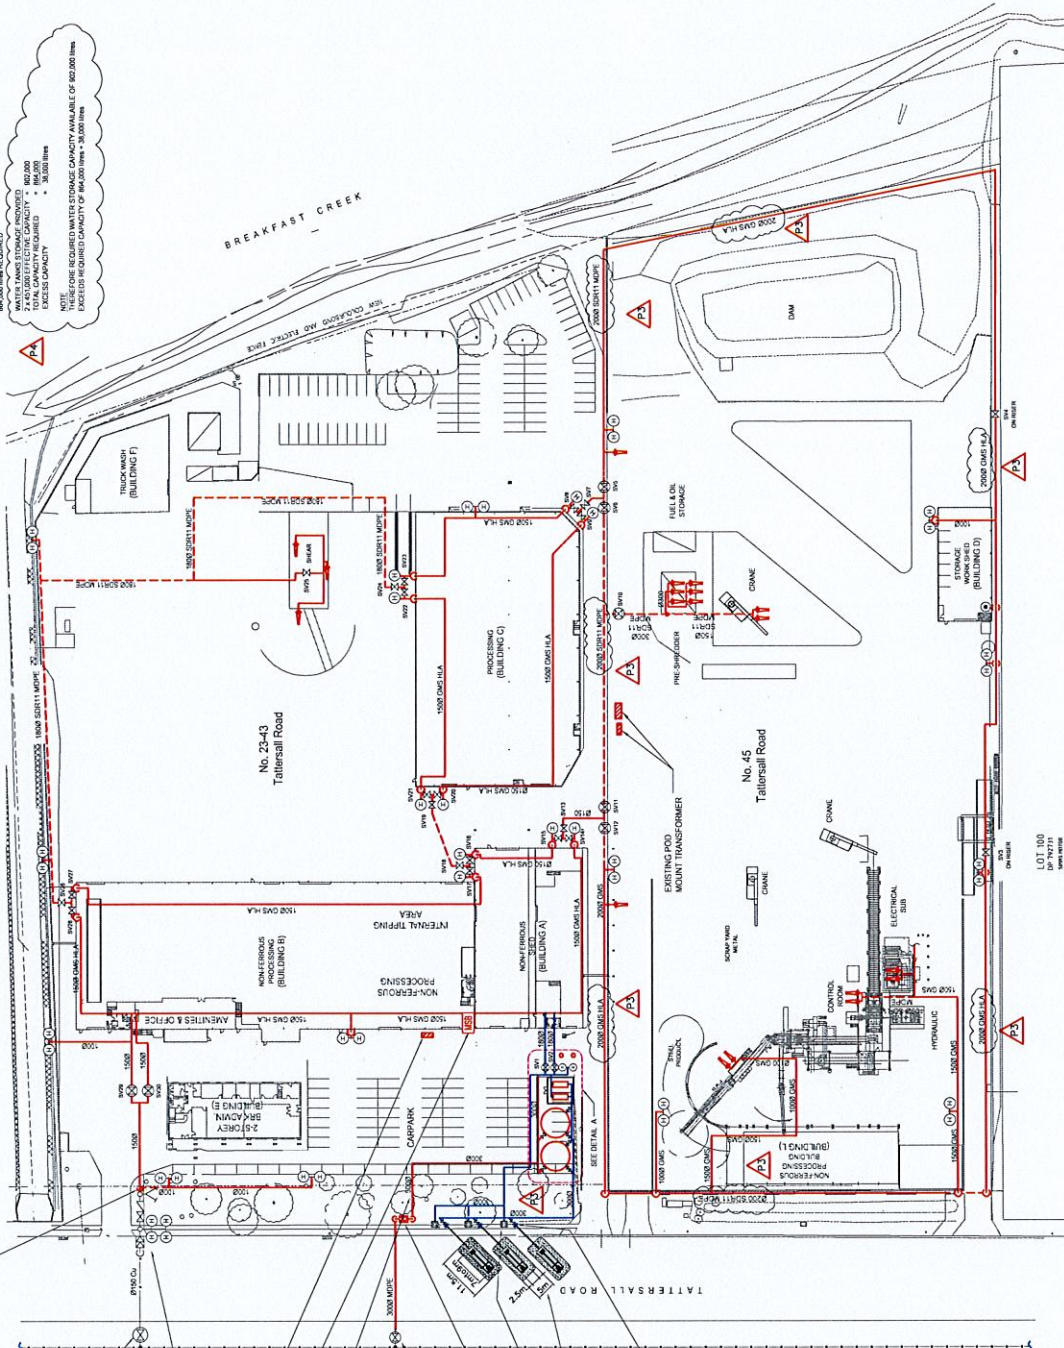

**LEGEND**

- ③ 50mm FIRE HOSE REEL
- ④ DOUBLE FIRE HYDRANT
- ⊗ ISOLATION VALVE IN GROUND
- ⊙ ISOLATION VALVE ABOVE GROUND
- ⊕ ROOSTER VALVE
- ⊖ STREET HYDRANT
- ⊚ MAIN ELECTRICAL SWITCHBOARD
- ⊙ FIRE HYDRANT CANON
- ⊚ FIRE HYDRANT CANON
- ⊚ 4" PIPING FROM TANK FUNCTION OUTLET & BUTTERFLY VALVE
- ⊚ 4" PIPING FROM TANK TYPE ROOSTER VALVE

**NOTES**

1. HEIGHT OF HIGHEST HYDRANT: 0.75 mms.
2. WATER COLUMN LOW VALVE: 100m.
3. WATER COLUMN LOW VALVE: 100m.
4. TOTAL FLOW RATE: 110 L/S.

EXISTING FIRE HYDRANT VALVE IN BOX TO BE REMOVED

EXISTING FIRE HYDRANT WATER CONNECTION TO BE DISCONNECTED
































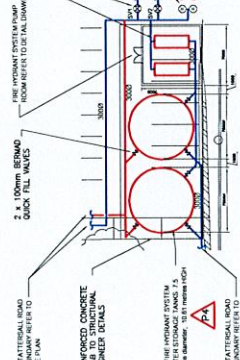

www.dialbeforeyoudig.com.au

**DIAL 1100 BEFORE YOU DIG**

NO.	REVISION	DATE	BY	APPROVED BY
1	PRELIMINARY	08/05/17		
2	ISSUES DOCKED, PIPES BETWEEN SITES CONNECTED	08/07/17	M.H.	


**CLIENT:** COMMERCIAL INDUSTRIAL BUILDINGS  
 23-43 + 45 Tattersall Road,  

**TITLE:** COMBINED SITE PLAN  
 FIRE HYDRANT & WATER CANON SYSTEMS

**PROJECT NO.:** 14\_023\_16-001\_PA\_EH-01

**DATE:** 14\_02\_16

**DESIGNER:** M.J.H. HAREY & ASSOCIATES PTY LTD.  
 PHONE: (02) 9758 8578 Fax: (02) 97588641


**CLIENT:** DEON SELL & PARKER  
 23-45 TATTERSALL ROAD  
 PHONE: (02) 9758 8578 Fax: (02) 97588641

**DATE:** 08/05/17  
**BY:** M.H.  
**CHECKED:** M.H.  
**DATE:** 27/08/16  
**PROJECT NUMBER:**

**NO.** **REVISION** **DATE** **BY** **APPROVED BY**

# PROPOSED ALTERATIONS TO EXISTING RECYCLING CENTRE 23-43 & 45 TATTERSALL RD, KINGS PARK LANDSCAPE

DRAWINGS	DWG NO.	DRAWING TITLE	SCALE
	000	COVERSHEET	N/A
	101	LANDSCAPE MASTERPLAN	1:500
	401	LANDSCAPE PLAN	1:250
	402	LANDSCAPE PLAN	1:250
	403	LANDSCAPE PLAN	1:250
	404	LANDSCAPE PLAN	1:250
	501	LANDSCAPE DETAILS	AS SHOWN

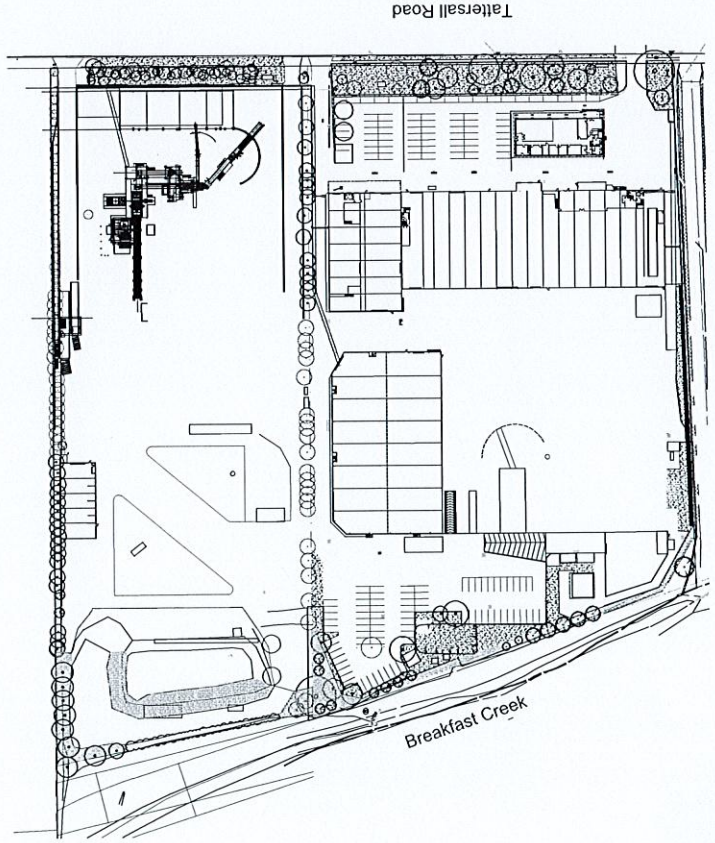

© 2016 Site Image Pty Ltd. All rights reserved. This drawing is the property of Site Image Pty Ltd and is not to be reproduced, stored in a retrieval system, or transmitted in any form or by any means, electronic, mechanical, photocopying, recording, or by any information storage and retrieval system, without the prior written permission of Site Image Pty Ltd. The contractor shall verify all work on site including work by others before commencing the landscape installation. Any alterations are to be made to the drawing at the contractor's risk. Do not make any changes. Any required consultation not shown shall be referred to the Landscape Architect for confirmation.

REV	DATE	DESCRIPTION
1	15.08.2017	Final Design
2	15.08.2017	Final Design
**LEGEND**

- I LCC Dimensions
- H Revised Contour
- G Revised for the Services
- E Revised for the Services
- E Revised for the Services
- C Construction conditions
- B General Revision
- A Proposed Installation
- Note Revision Description

Key Plan:



Client:  
Sell and Parker Pty Ltd

Project:  
Proposed Alterations to  
Existing Recycling Center  
23 & 45 Tattersall Rd, Kings Park

SITE IMAGE  
Landscape Architects  
Level 1, 15, South Street  
Sydney NSW 2018  
Australia  
Tel: (61 2) 9633 3677  
Fax: (61 2) 9633 3677  
www.siteimage.com.au  
Site Image Pty Ltd  
ABN 62 742 282

CONSTRUCTION CERTIFICATE  
Drawing Name:  
Coversheet

Scale:  
Job Number:  
Drawing Number:  
Sheet:  
SS15-3178  
000 1

NOT FOR CONSTRUCTION

© 2018 Site Image (NSW) Pty Ltd. All rights reserved. This drawing is copyright and the property of Site Image (NSW) Pty Ltd. It is not to be reproduced, stored in a retrieval system, or transmitted in any form or by any means, electronic or mechanical, including photocopying, recording, or by any information storage or retrieval system, without the written permission of Site Image (NSW) Pty Ltd. 

Drawn	Checked	Date
JL	NM	22.03.2017
SM	NM	23.03.2017
SM	NM	13.02.2017
SM	NM	31.01.2017
JL	NM	18.12.2016
JL	NM	18.12.2016
SM	NM	04.10.2016
SM	NM	15.09.2016
JW	NM	17.02.2016
JW	NM	17.02.2016

- J LEC Amendments
- A Approved for construction
- C Approved for construction
- H Revised for the services
- I Updated landscaping
- E Updated landscaping
- D Construction certificate
- B General Remarks
- A For Comment
- None Revision Description

**LEGEND**

- Site Boundary
- Existing vegetation to be retained, with additional landscape vegetation
- Turf
- Existing tree to be removed
- Existing tree to be retained
- Proposed tree planting



Client: Sell and Parker Pty Ltd

Project: Proposed Alterations to Existing Recycling Center  
23 & 45 Tattersall Rd, Kings Park

**SITE IMAGE**




Level: 1 - 3d Project Close  
Date: 17/02/2018  
Australia  
Tel: (61 2) 8332 0000  
www.siteimage.com.au  
Site Image (NSW) Pty Ltd  
Abn 64 601 742 280

**CONSTRUCTION CERTIFICATE**  
Landscape Masterplan

Drawing Name:

Scale: 1:500 @ A1  
Job Number: 101 J  
Drawing Number: SS-15-3178

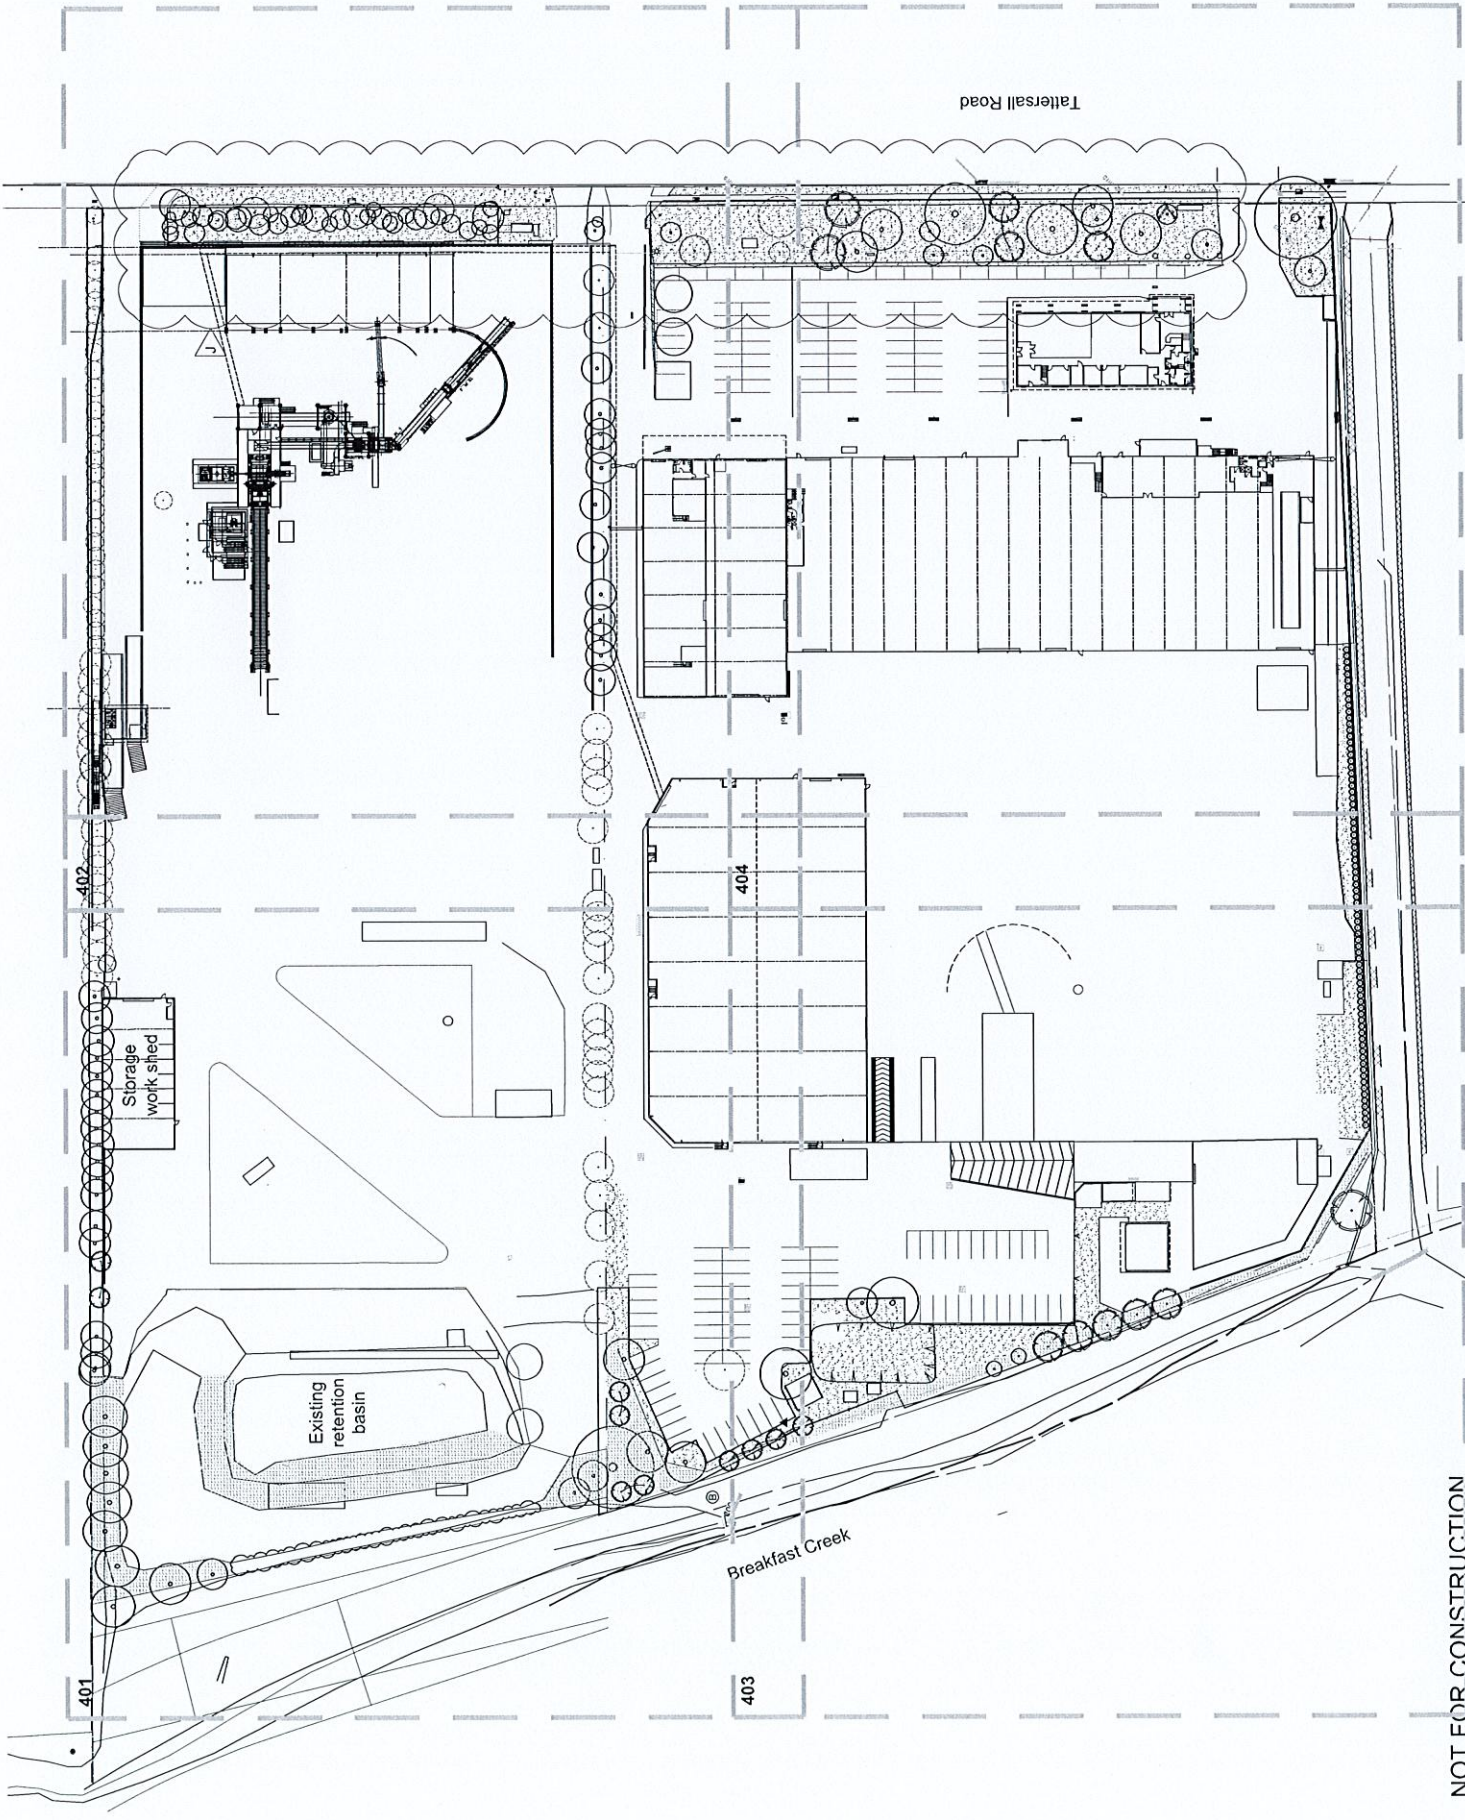

NOT FOR CONSTRUCTION


© 2014 Site Image (NSW) Pty Ltd. All rights reserved. This drawing is copyright and may not be reproduced, stored in a retrieval system, or transmitted in any form or by any means, electronic or mechanical, including photocopying, recording, or by any information storage or retrieval system, without the written permission of Site Image (NSW) Pty Ltd. 



JD 18/12/2017  
 JD 18/12/2018  
 SM 04/03/2016  
 JW 17/03/2016  
 JW 17/03/2016  
 JW 17/03/2016  
 JW 17/03/2016


Legend:  
 [Symbol] Site boundary  
 [Symbol] Existing vegetation to be retained  
 [Symbol] Existing vegetation to be removed  
 [Symbol] Turf  
 [Symbol] Existing trees to be retained  
 [Symbol] Existing trees to be removed  
 [Symbol] Proposed new planting

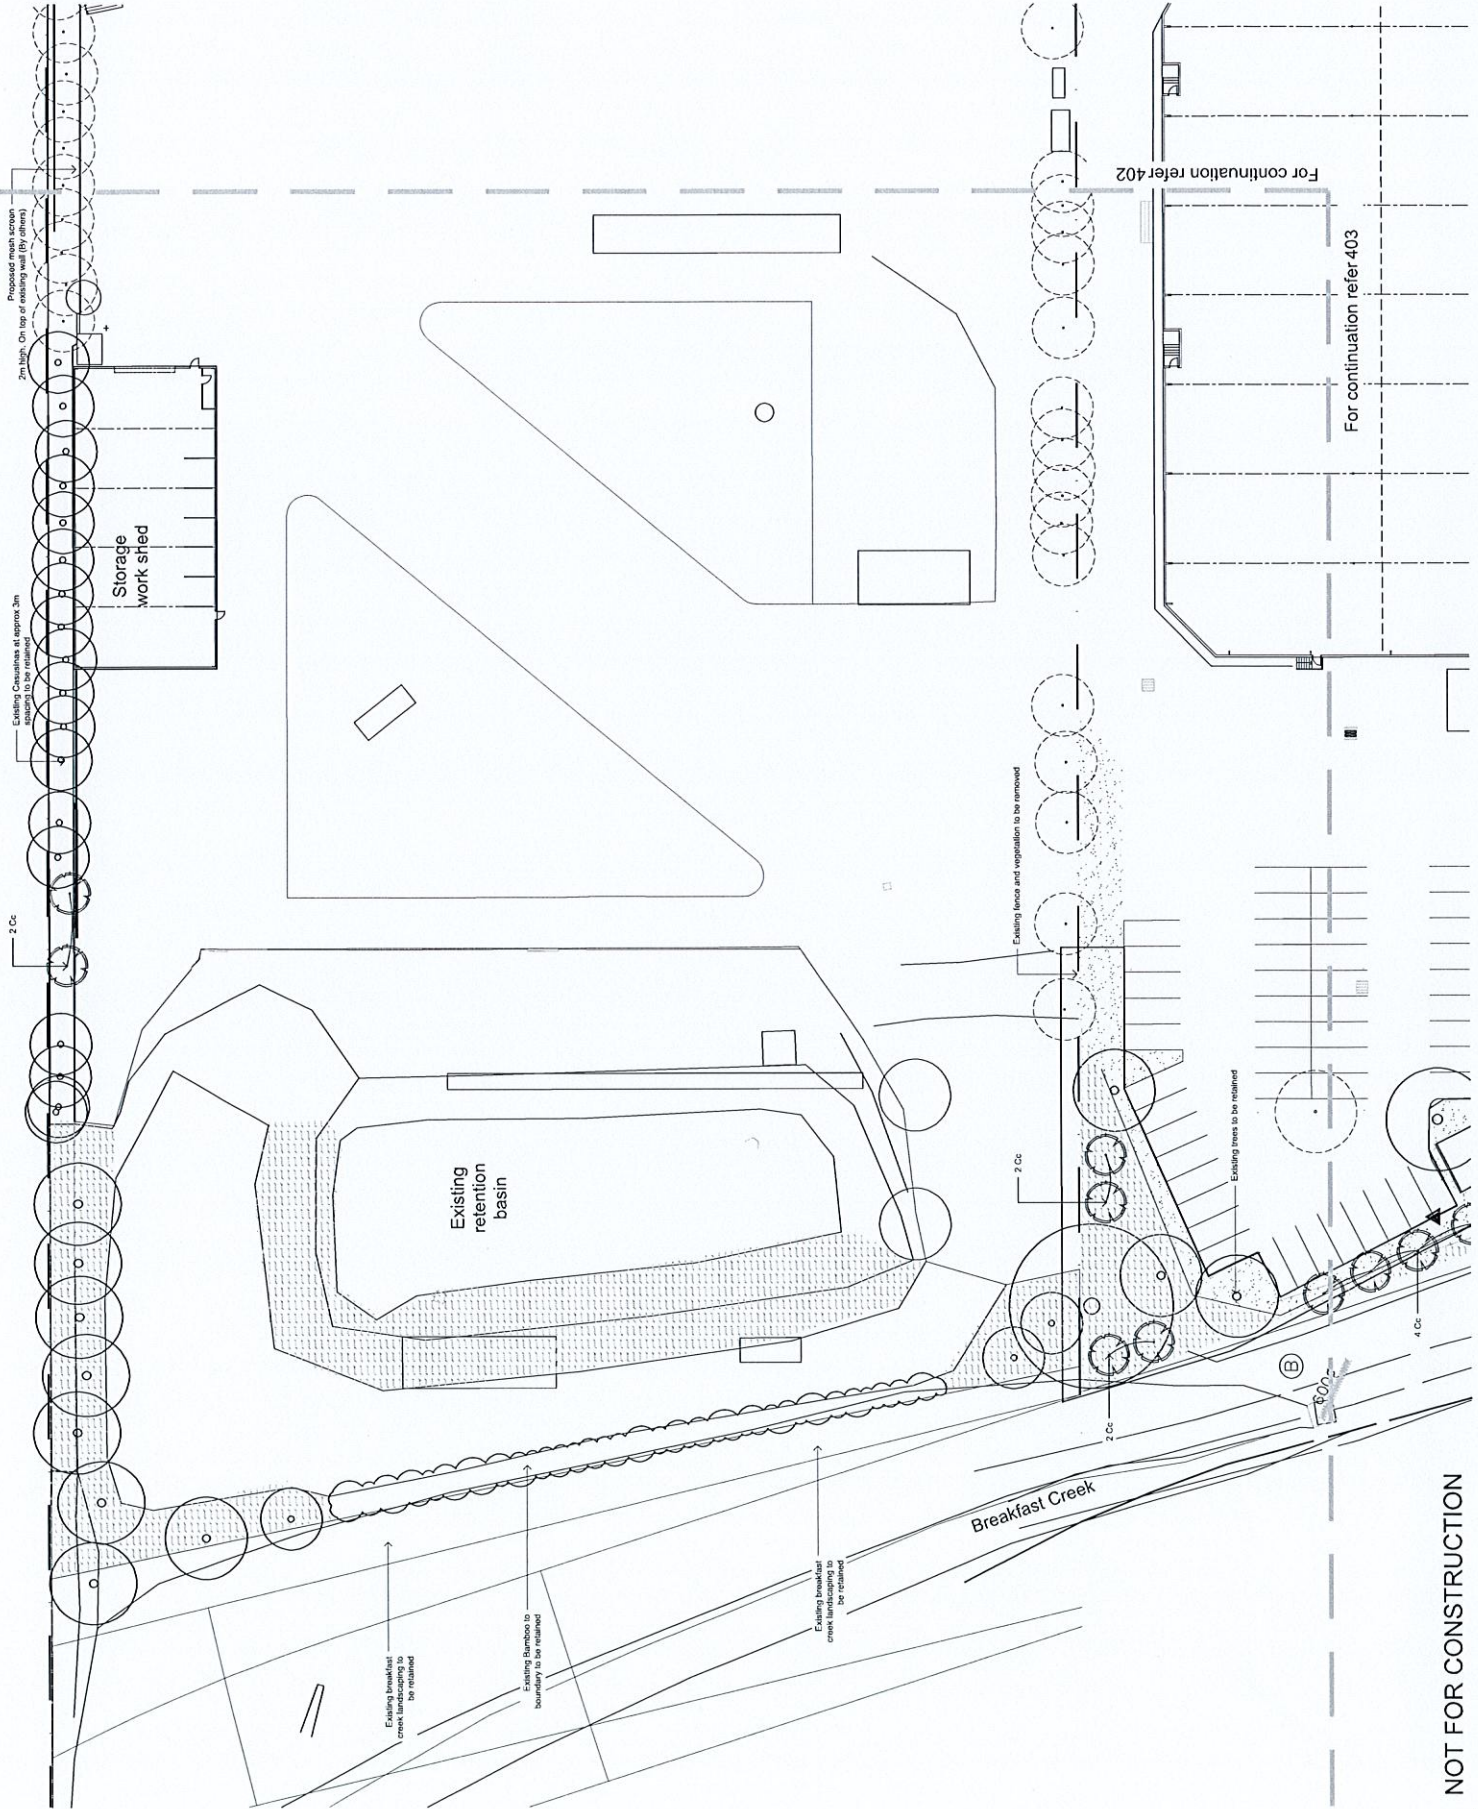



Storage  
work shed

Existing  
retention  
basin

Breakfast Creek

For continuation refer 402

For continuation refer 403

NOT FOR CONSTRUCTION

Client: Sell and Parker Pty Ltd

Project: Proposed Alterations to Existing Recycling Center 23 & 45 Tattersal Rd, Kings Park

SITE IMAGE  
 Level 1, 35, Bruce Street  
 Sydney NSW 1587  
 Australia  
 Tel: (61) 2 9333 5602  
 Fax: (61) 2 9333 5603  
 www.siteimage.com.au  
 Site Image (NSW) Pty Ltd  
 ABN 64 631 392 380

CONSTRUCTION CERTIFICATE  
 Landscape Plan

Drawing Name:  
 Scale: 1:250 @ A1  
 Job Number: SS15-3178  
 Drawing Number: 401 G  
 Sheet: 401 G







JD	NM	15.03.2017
JR	NM	15.03.2017
JL	NM	15.03.2016
JM	NM	04.03.2016
Other	Check	0/00

G	Revised drawing
H	Revised drawing
I	Revised drawing
**LEGEND**

[Symbol]	Site Boundary
[Symbol]	Existing vegetation to be retained, with additional irrigated vegetation
[Symbol]	Turf
[Symbol]	Existing tree to be removed
[Symbol]	Existing tree to be retained
[Symbol]	Proposed tree planting




Client: **Sell and Parker Pty Ltd**

Project: **Proposed Alterations to Existing Recycling Center 23 & 45 Tattersall Rd, Kings Park**

**SITE IMAGE**  
 www.siteimage.com.au  
 Site Image Pty Ltd  
 ABN 49 149 209 121

**CONSTRUCTION CERTIFICATE**  
 Drawing Name: **Landscape Plan**

Scale: 1:250 @ A1  
 Drawing Number: **403 G**  
 Job Number: **SS15-31178**

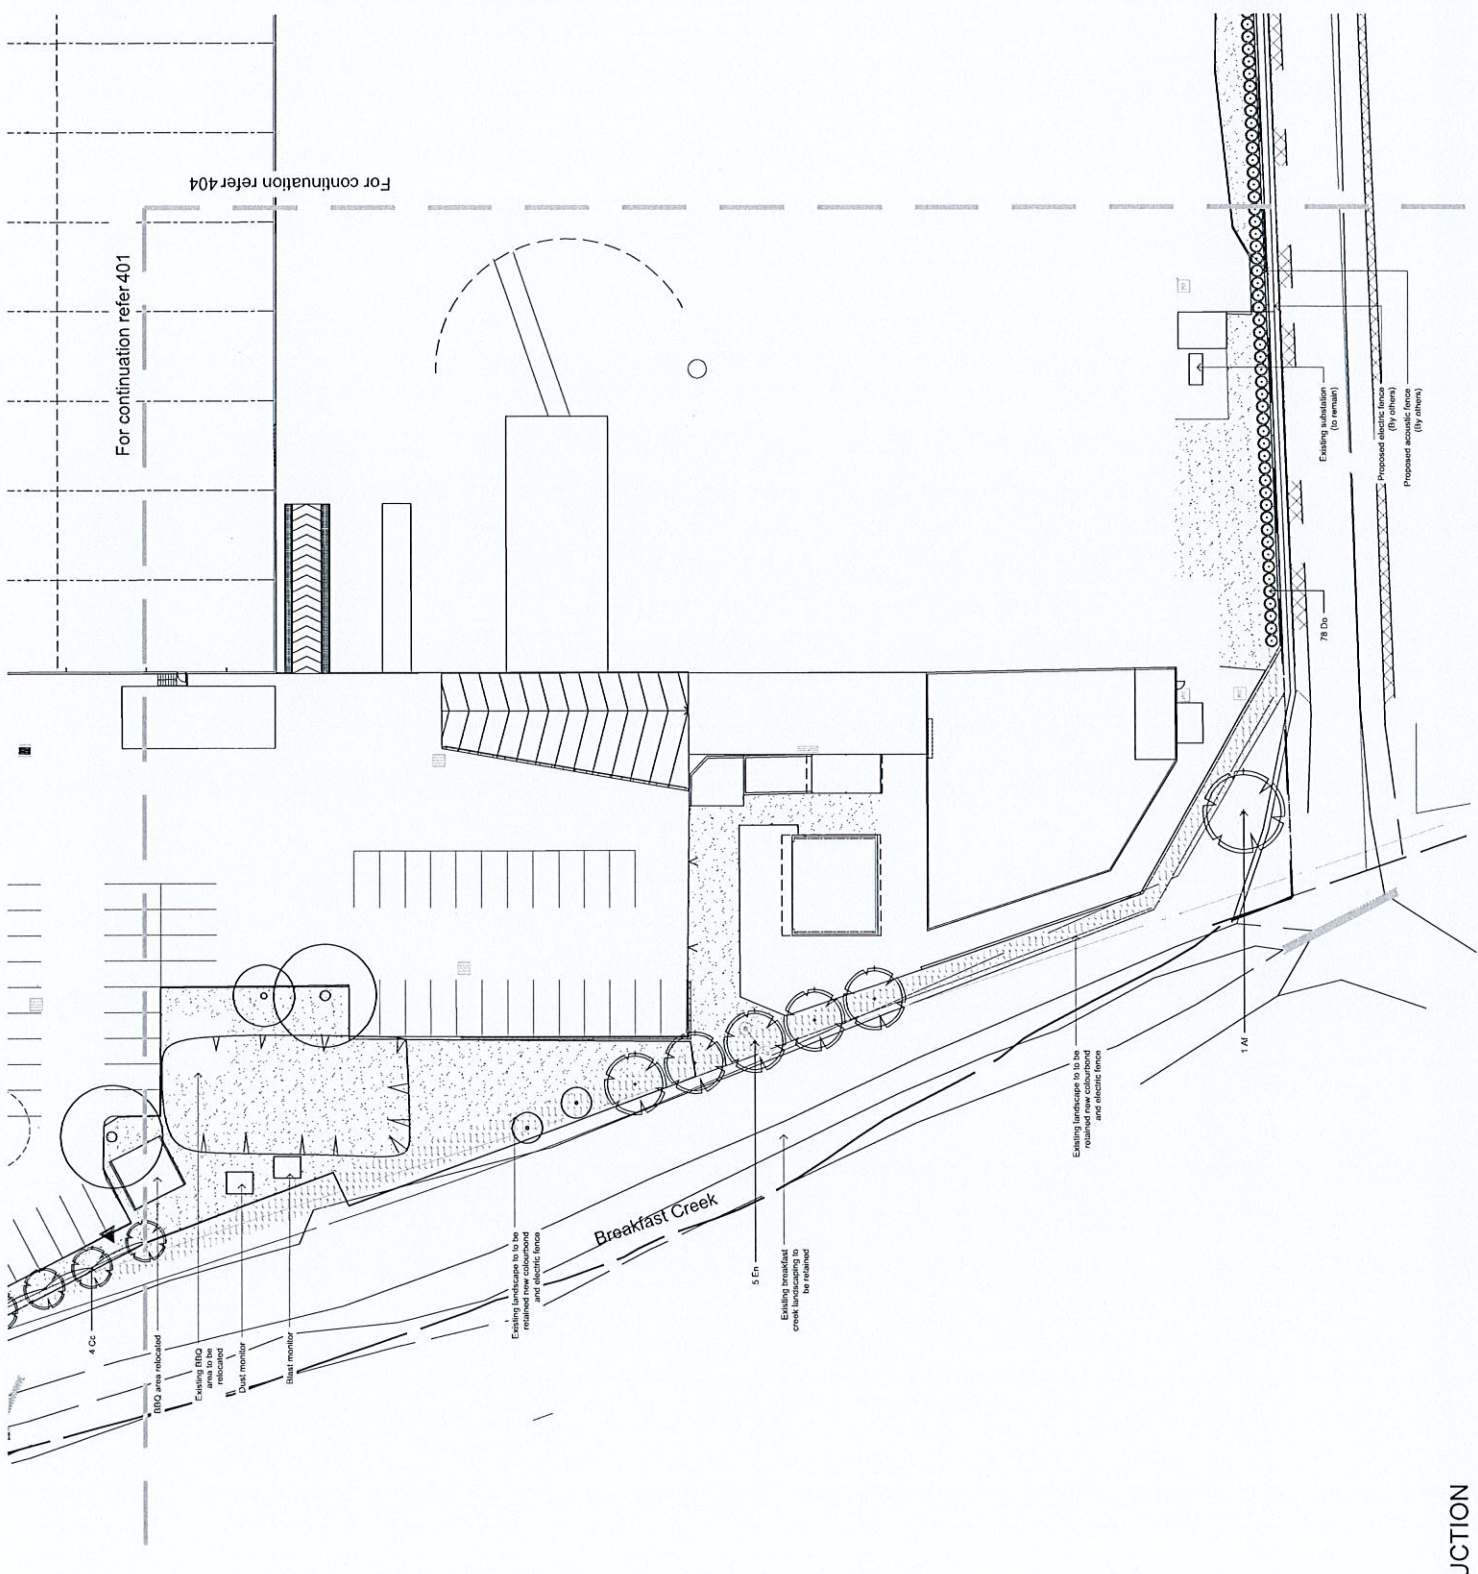

**NOT FOR CONSTRUCTION**




JD	NS	22.08.2017
JD	NS	19.08.2017
JD	NS	13.03.2016
SM	NS	04.10.2016
SM	NS	04.10.2016
JW	NS	17.03.2016
JW	NS	13.02.2016
JW	NS	13.02.2016
Drawn	Check	Date

- G LEC Alterations
- E Existing site plan
- E Existing site plan
- D Construction certificate
- S Site plan
- S General location
- A For Client
- Notes Revision description

**LEGEND**

	Site boundary
	Existing vegetation to be retained
	Existing vegetation to be removed
	Turf
	Existing trees to be retained
	Existing trees to be removed
	Proposed tree planting

Key Plan:



Client: Sell and Parker Pty Ltd

Project: Proposed Alterations to Existing Recycling Center 23 & 45 Tattersall Rd, Kings Park

SITE IMAGE



Level 1, 3rd Floor Street  
 Australia  
 Tel: 011 2 8322 5600  
 Fax: 011 2 8322 5601  
 www.siteimage.com.au  
 Site Image (NSW) Pty Ltd  
 ABN 44 611 742 380

CONSTRUCTION CERTIFICATE


Drawing Name: Landscape Plan

Scale: 1:250 @ A1

Job Number: SS15-3178

Drawing Number: 404

Sheet: G

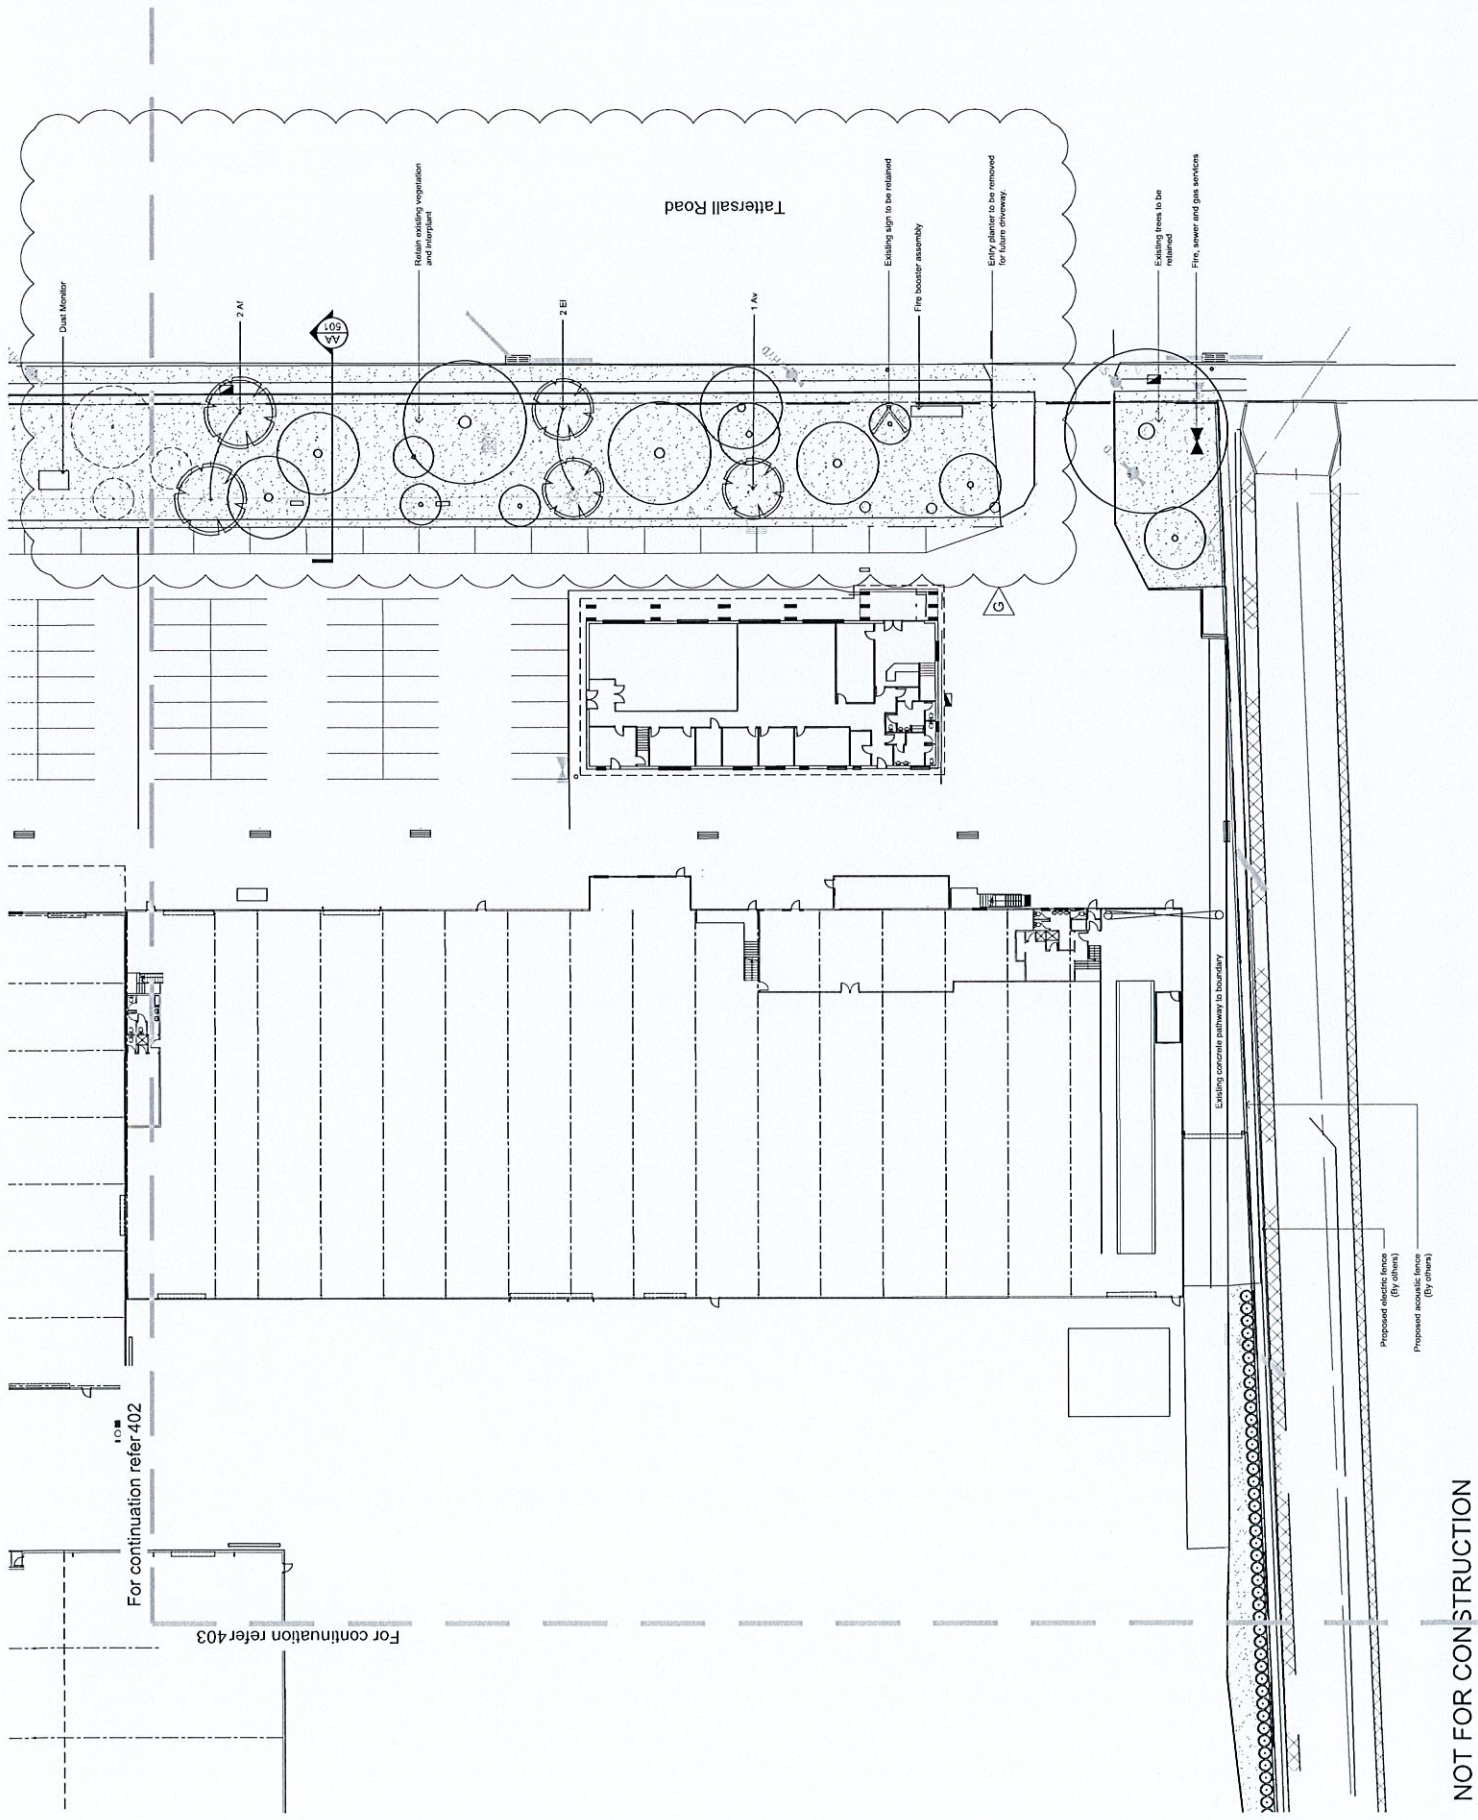

For continuation refer 402

For continuation refer 403

NOT FOR CONSTRUCTION




**LEGEND**



### Maintenance Schedule


Table	ACTIVITY	FREQUENCY				ACTION
		1	2	3	4	
1	Logbook	+	+	+	+	Complete a logbook entry every day at site and fill in at least every two weeks. The logbook should be maintained in a logbook folder. Upon request, make the logbook available for inspection. 







11	Watering	+	+	+	+	Water plants and water necessary every day at site and at least every 2 weeks. Watering should be done to maintain the health of the plant. 
12	Mowing, top-dressing and edging	+	+	+	+	Mow lawns every 2 weeks. Top-dress lawns as necessary. Edging should be done to maintain the health of the plant. 

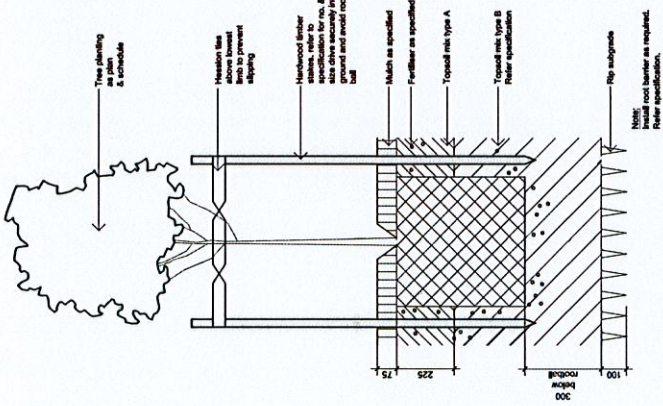

**DETAIL - 75-200L TREE PLANTING ON GRADE**  
SCALE 1:10

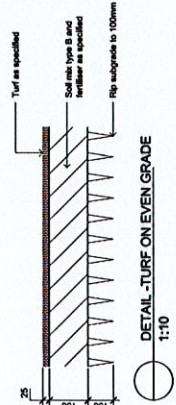

**DETAIL - TURF ON EVEN GRADE**  
SCALE 1:10

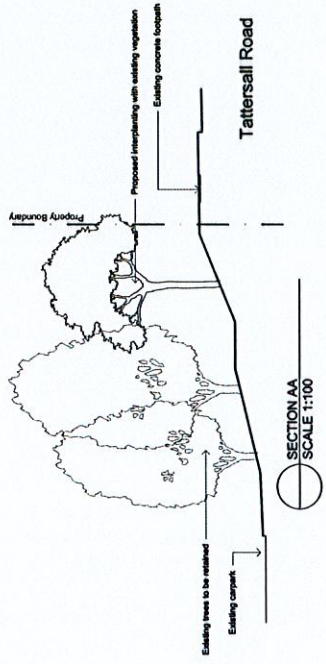

**SECTION AA**  
SCALE 1:100

Symbol	Botanic Name	Common Name	Mature Size (h x w)	Pod Size	Spreading	Qty
<b>TREES</b>						

**Sell and Parker Pty Ltd**

**Proposed Alterations to Existing Recycling Center**  
23 & 45 Tattersall Rd, Kings Park

**SITE IMAGE**

**CONSTRUCTION CERTIFICATE**


**Landscaping Details**

Scale: 1:250 @ A1  
Job Number: SS15-3178  
Drawing Number: 501 I

NOT FOR CONSTRUCTION